
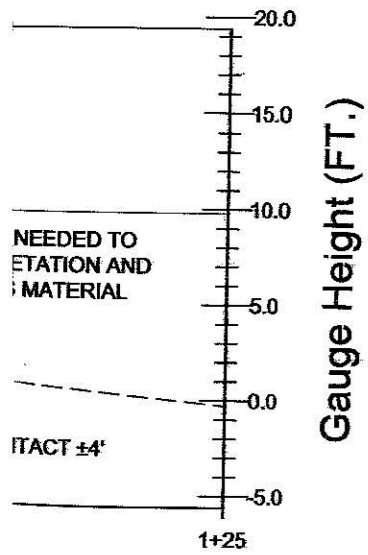


**TYPICAL CREST SURFACING DETAIL
NOT TO SCALE**

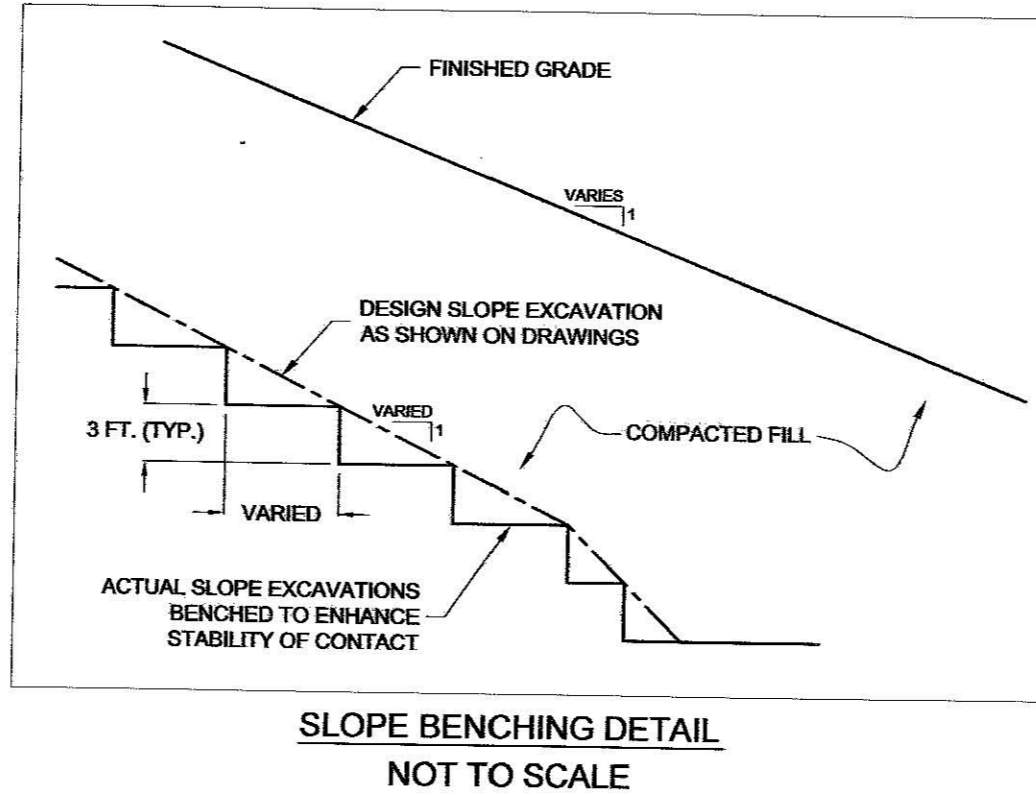

REVISION	DATE	BY	CHK
△ C	ISSUED FOR BID	2/24/10	KR TEK
△ D	ISSUED FOR STATE REVIEW	7/22/10	KR EH
△ E	ISSUED FOR CONSTRUCTION	7/28/10	KR WLN
△ F	AS-CONSTRUCTED	6/29/11	KR WLN

DATE	June 29, 2011
PROJECT	413200
TASK NUMBER	01
DRAWN BY	KR
PROJECT ENGINEER	SM / KS
CHECKED BY	WN

**EMBANKMENT
SECTIONS AND
DETAILS**

SHEET NUMBER: 3 / 4	REVISION NUMBER: △ F
------------------------	-------------------------

PREPARED BY:
TELESTO
SOLUTIONS INCORPORATED

PREPARED FOR:
THE LOUDEN IRRIGATION CANAL
AND RESERVOIR COMPANY